


- SUSPENDED SLAB NOTES:
- REFER TO ARCHITECTURAL DRAWINGS FOR ALL LEVELS, STEPS, SET-DOWNS, FALLS ETC.
 - WHERE ARCHITECT'S DRAWINGS INDICATE FALLS IN SLAB, STRUCTURAL SIZES SHOWN ARE THE MINIMUM ALLOWABLE THICKNESS.
 - ALL BALCONY AND ROOF SLABS TO BE WATERPROOFED TO ARCHITECT'S DETAILS U.N.O.
 - REFER TO ARCHITECTURAL DRAWINGS FOR BALUSTRADE TYPES AND EXTENTS.
 - ALL NON-LOAD BEARING WALLS HAVE BEEN ASSUMED TO BE CONSTRUCTED USING LIGHTWEIGHT MATERIALS.

- FRAMING PLAN:
- REFER TO ARCHITECTURAL DRAWINGS FOR ALL LEVELS, STEPS, SET-DOWNS, FALLS AND EXTENT OF WORKS.
 - ALL SERVICES TO BE COORDINATED WITH THE STRUCTURAL PLANS.
 - meySPAN BEARERS AND JOISTS TO BE INSTALLED IN ACCORDANCE WITH MANUFACTURERS SPECIFICATIONS.
 - ALL EXTERNAL STEELWORK & STEELWORK IN CONTACT WITH EXTERNAL WALLS TO BE HOT DIP GALVANISED, ALL OTHER STEELWORK TO BE PRIMED & PAINTED IN ACCORDANCE WITH THE ARCHITECTURAL REQUIREMENTS.
 - ALL TIMBER FRAMING AND BRACING TO BE IN STRICT ACCORDANCE WITH AS1684 & NATIONAL CONSTRUCTION CODE.
 - PROVIDE 90 x 90 MGP10 POSTS OR DOUBLE 90 x 45 MGP10 STUDS TO SUPPORT ALL BEAMS, LINTELS, GIRDER TRUSSES AND HIP TRUSSES UNLESS NOTED OTHERWISE.
 - PROVIDE PRYDA STUD TIES TO TOP & BOTTOM PLATES EACH SIDE OF OPENINGS IN LOAD BEARING INTERNAL/EXTERNAL WALLS.
 - FIX BOTTOM PLATE OF STUD WALLS TO THE FLOOR @ 900 CTS, EITHER SIDE OF OPENINGS AND AT BASE OF ALL BRACING LOCATIONS TO SLAB WITH 1/M12 DYNA BOLT.
 - PROVIDE 8mm FIN PLATES WITH M12 BOLTS BETWEEN STEEL COLUMNS & TIMBER BEAMS & LINTELS.
 - PROVIDE 38x1.2mm GALVANISED FLAT METAL STRAP TENSION ROOF BRACING TO ALL ROOF AREAS INSTALLED IN ACCORDANCE WITHH AS1684 RESIDENTIAL TIMBER FRAMING.
 - TRIP-L-GRIP TRUSSES, RAFTERS, PURLINS, ETC TO TOP PLATE. STRAP TOP & BOTTOM PLATES TO EVERY SECOND STUD, USING PYRDA STUD TIES.

LEGEND

-  DENOTES PENETRATION IN SLAB
-  DENOTES EXTENT OF 30mm SETDOWN FOR WET AREAS
-  DENOTES BRICKWORK WALLS BELOW
-  DENOTES STEEL POST ABOVE & BELOW
-  DENOTES FULL HEIGHT STEEL POST

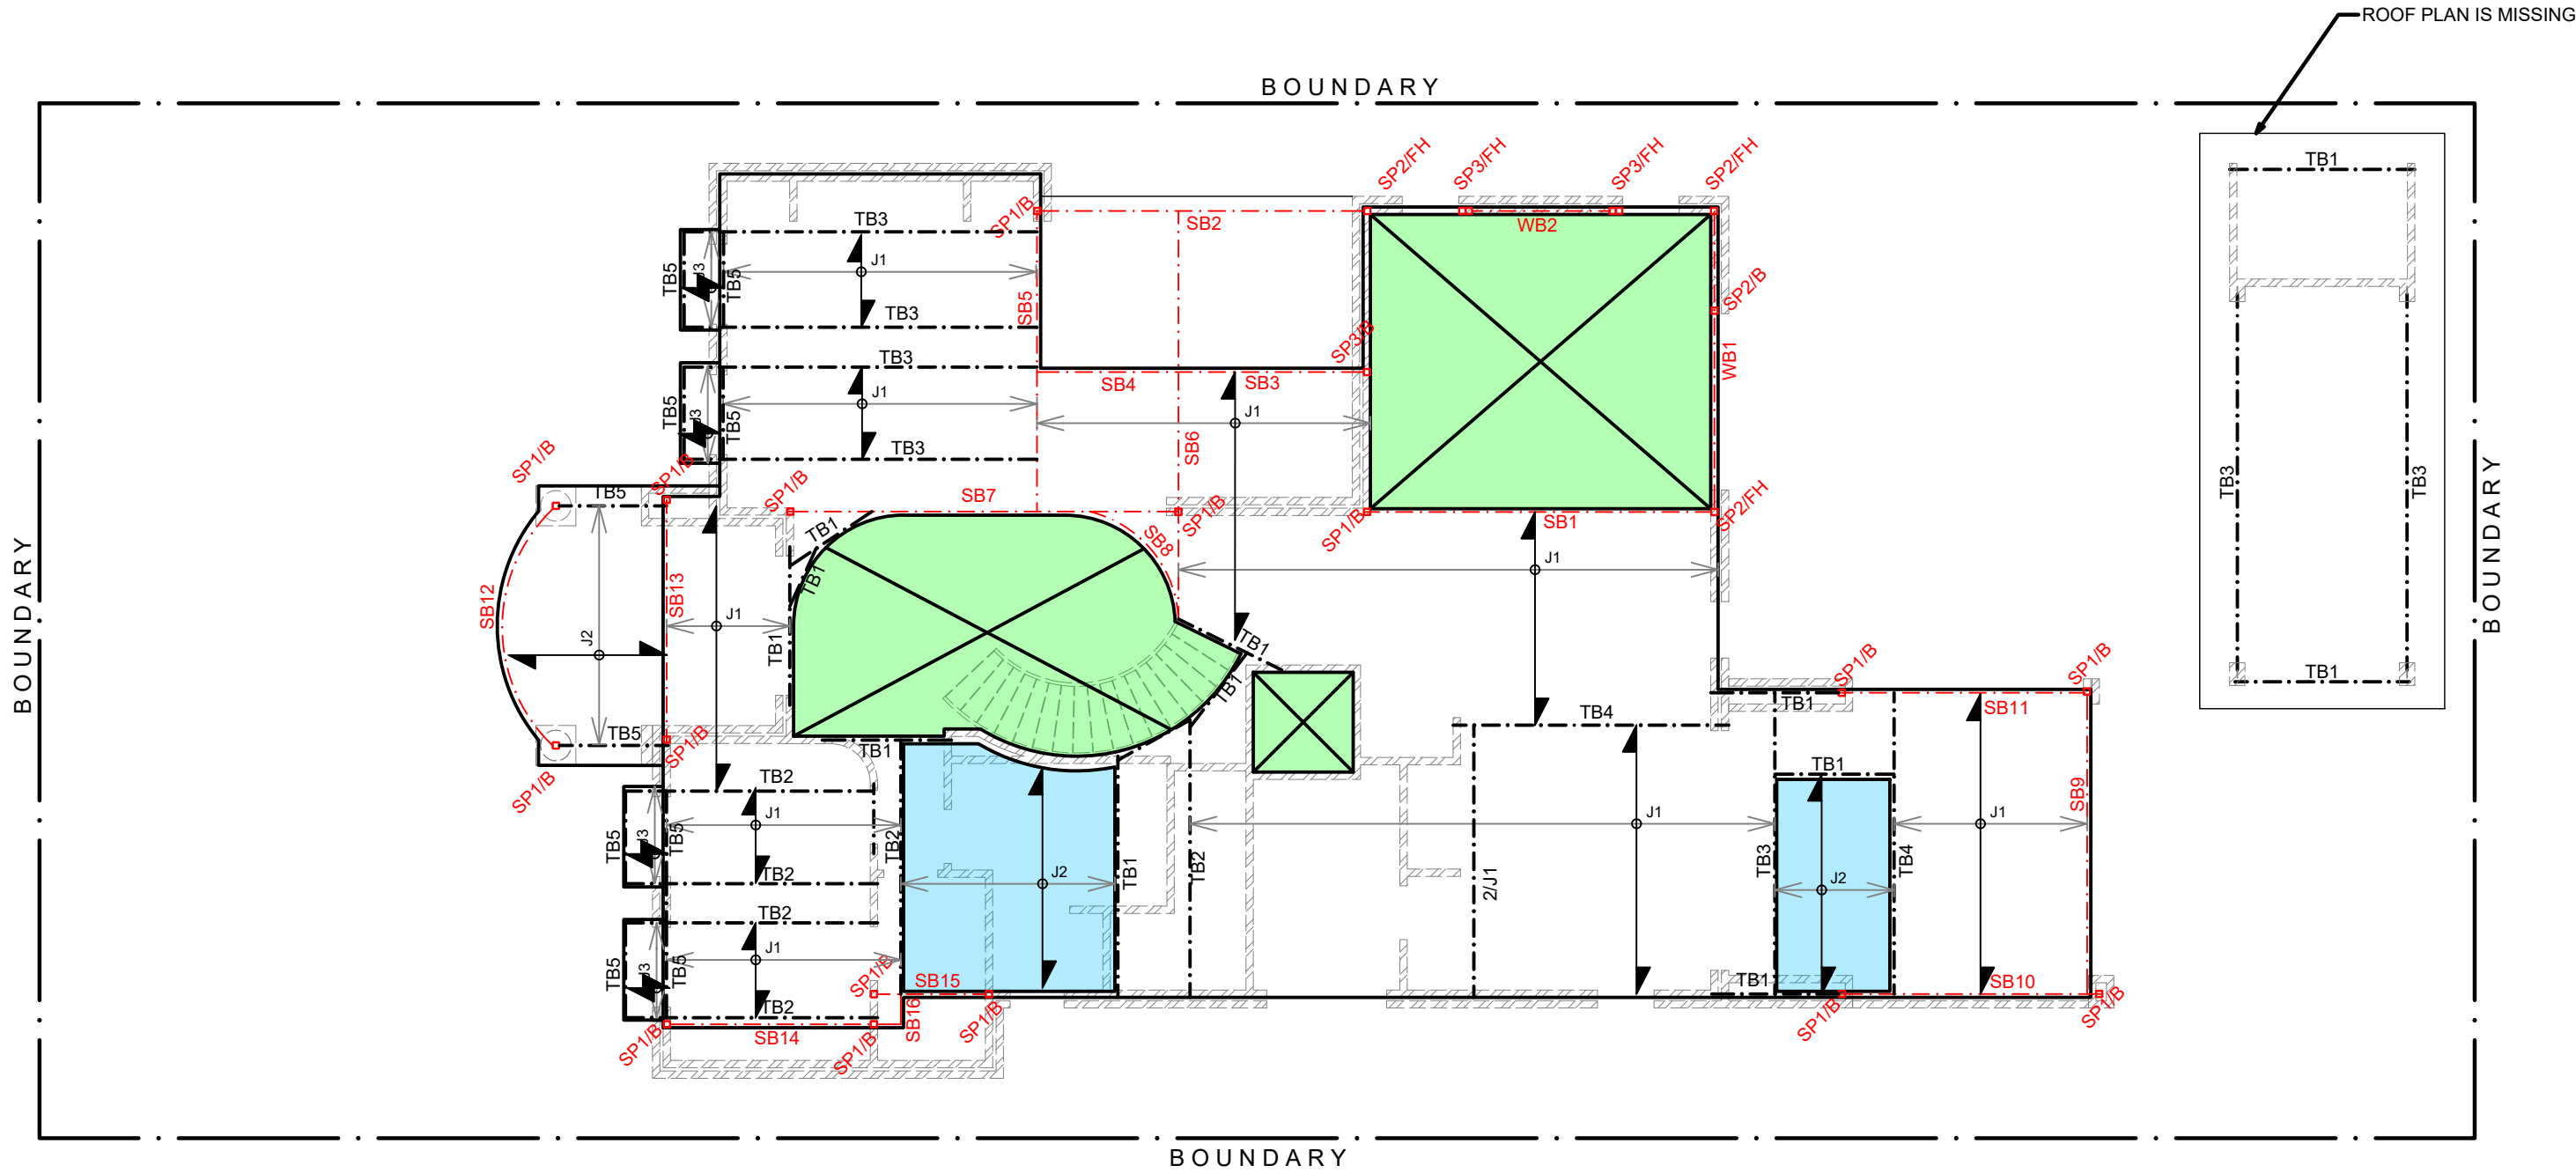

FIRST FLOOR PLAN

SCALE 1:100

FLOOR LOADING ASSUMPTION		ROOF LOADING ASSUMPTION	
FIRST FLOOR	HEBEL	LOWER ROOF	TILED (90kg/m²)
ALL WET AREAS	TILED	MAIN ROOF	TILED (90kg/m²)
FIRST FLOOR WALL ASSUMPTION			
EXTERNAL WALL		DOUBLE BRICK	
INTERNAL WALLS		SINGLE BRICK	
	<u>STEEL POST SCHEDULE</u>		
	MARK	SIZE	
	SP1	89 x 89 x 6mm SHS	
	SP2	100 x 100 x 6mm SHS	
	SP3	2 / 100 x 100 x 6mm SHS	
	<u>STEEL MEMBER SCHEDULE</u>		
	MARK	SIZE	
	WB1	150 x 9mm SHS	
	WB2	250 PFC	
	SB1	310 UB 40.4	
	SB2	300 PFC	
	SB3	250 PFC + 200 x 10 MS PLATE	
	SB4	250 PFC + 200 x 10 MS PLATE	
	SB5	300 PFC + 200 x 10 MS PLATE	
	SB6	310 UB 46.2	
	SB7	310 UB 46.2	
	SB8	300 PFC (CURVED)	
	SB9	250 PFC + 200 x 10 MS PLATE	
	SB10	250 PFC + 200 x 10 MS PLATE	
	SB11	250 PFC + 200 x 10 MS PLATE	
	SB12	300 PFC (CURVED)	
	SB13	250 PFC + 200 x 10 MS PLATE	
	SB14	250 PFC + 200 x 10 MS PLATE	
	SB15	250 PFC + 200 x 10 MS PLATE	
	SB16	250 PFC + 200 x 10 MS PLATE	
	<u>TIMBER MEMBER SCHEDULE</u>		
	MARK	SIZE	
	TB1	1 / 300 x 63 meySPAN LVL13	
	TB2	2 / 300 x 45 meySPAN LVL13	
	TB3	2 / 300 x 63 meySPAN LVL13	
	TB4	3 / 300 x 63 meySPAN LVL13	
	<u>TIMBER JOIST SCHEDULE</u>		
	MARK	SIZE	
	J1	300 x 63 meyJOISTS @ 450 CTS.	
	J2	240 x 45 meyJOISTS @ 450 CTS.	
	J3	190 x 45 MGP10 @ 450 CTS.	

NOTE:
SOME DETAILS PROVIDED ON THIS PAGE MAY NOT BE APPLICABLE TO THIS JOB, BUILDER / CONTRACTORS TO REVIEW AND CONFIRM DETAILS AS REQUIRED. IF IN DOUBT CONTACT ENGINEER FOR FURTHER ADVICE.

					CLIENT MR & MRS ATTAL PROJECT ADDRESS 143 DUBLIN STREET, SMITHFIELD	ARCHITECT	VANGUARD CONSULTING ENGINEERS E-MAIL: ADMIN@VCENG.COM.AU UNIT 1, 6 WELD STREET, PRESTONS, 2170 TEL: (02) 9145 0253 WEB: WWW.VCENG.COM.AU	JOB NUMBER V250168		
3	UPDATED PLAN	09.06.2026	H.N	A.N				SHEET NUMBER S300		REVISION 3
2	ISSUED FOR CDC	12.01.2026	N.P	D.Y				SCALE - 1:100		
1	ISSUED FOR CDC	26.05.2025	N.P	D.Y						
0	ISSUED FOR CC	04.04.2025	N.P	D.Y						
REVISION	AMENDMENT	DATE	DRAWN	DESIGN	FIRST FLOOR PLAN					